


IN RED INK. RECEIVED ON:
~~Oct 9, 1992~~
 August 17, 1990
 July 14, 1992



PRIMEX REALTY Assoc

MAP AND CERTIFICATIONS ARE NEITHER TRANSFERABLE TO UNLISTED ENTITIES NOR EXTENDABLE FOR SUBSEQUENT PURPOSES OR TRANSACTIONS EXCEPT BY SURVEY UPDATE.

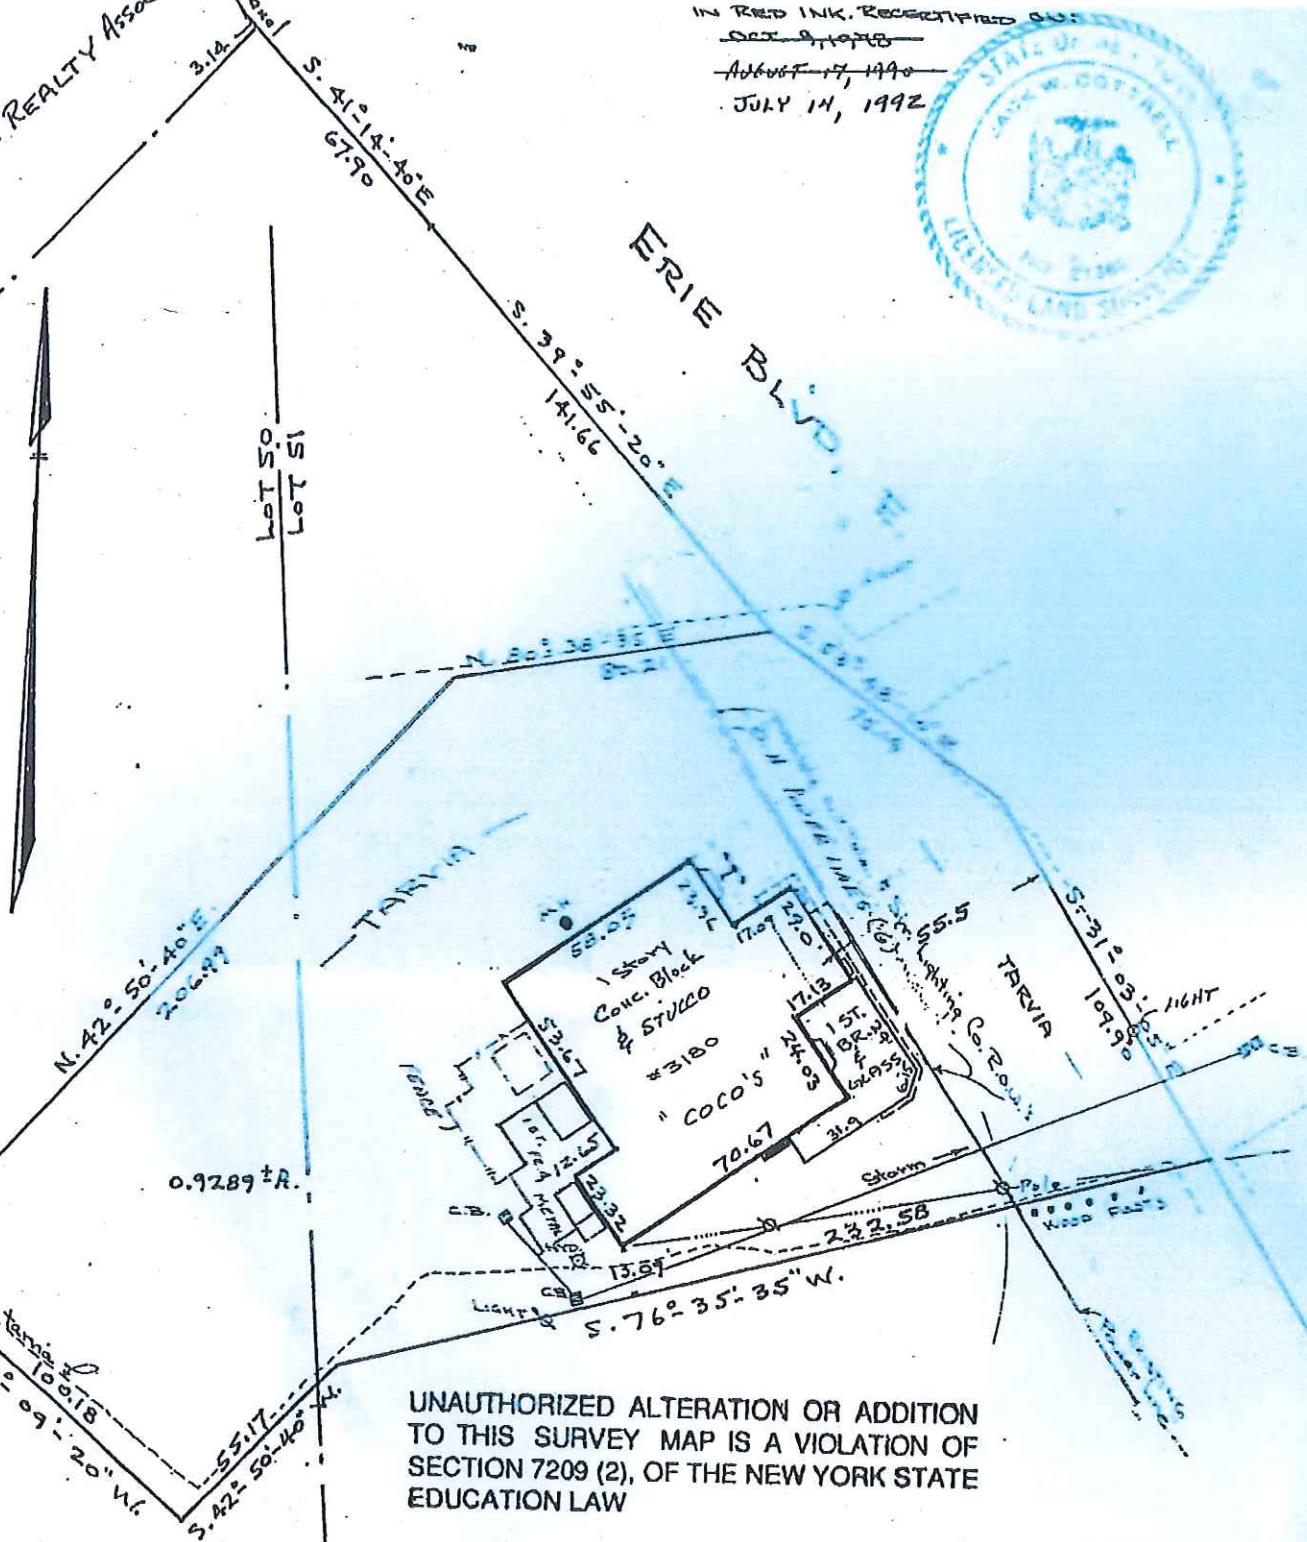

UNAUTHORIZED ALTERATION OR ADDITION TO THIS SURVEY MAP IS A VIOLATION OF SECTION 7209 (2), OF THE NEW YORK STATE EDUCATION LAW

ONLY THE ORIGINAL SURVEYING ENTITY CAN UPDATE AND RECERTIFY THIS SURVEY MAP. THE REFERENCE TO, USE OF OR RELIANCE ON THIS MAP BY ANOTHER SURVEYOR, FOR WHATEVER PURPOSE, VOIDS THE MAP AND CERTIFICATION. SAID USER ASSUMES SOLE RESPONSIBILITY FOR ALL ERRORS OR OMISSIONS. USE OF THIS MAP ACKNOWLEDGES THIS DISCLAIMER.

THE FOLLOWING ITEMS, IF MARKED, APPLY:
 ABSTRACT OF TITLE NOT FURNISHED
 ABSTRACT OF TITLE CURRENT ONLY AS OF:
 CERTIFICATION VOID

FOR PURCHASE & / MORTGAGE PURPOSES ONLY
 CIRCA THE LATEST CERTIFICATION DATE.

PART OF LOTS 50, 51 ~ TOWN OF DENITT
 ONONDAGA Co., N.Y.

Scale 1" = 50'
 June 26, 1962

COTTRELL LAND SURVEYORS, P.C.
 MANLIUS, N.Y.